



EXIST. POOL / DECK DEMOLITION
SCALE: 1/8"=1'-0"

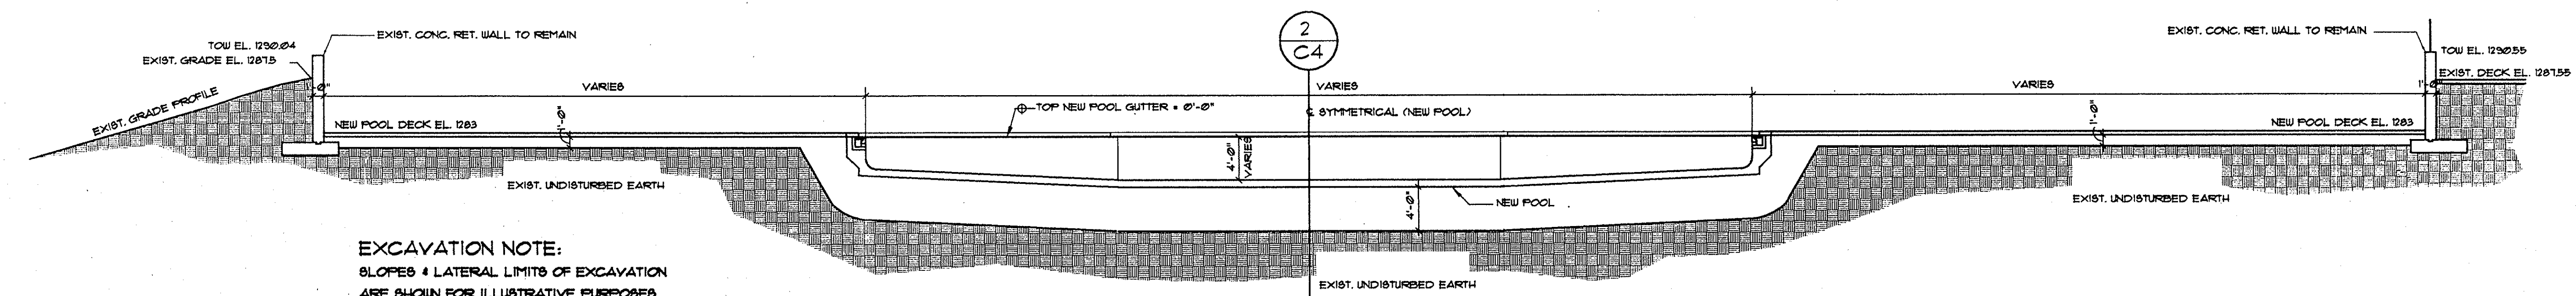

EXCAVATION NOTE:
SLOPES & LATERAL LIMITS OF EXCAVATION
ARE SHOWN FOR ILLUSTRATIVE PURPOSES
ONLY. EXCAVATION SLOPES & STABILITY
ARE THE RESPONSIBILITY OF THE CON-
TRACTOR & SHALL BE IN ACCORDANCE
WITH OSHA STANDARDS. LATERAL LIMITS
OF EXCAVATION WILL VARY WITH DEPTH &
WILL BE DETERMINED BY GEOTECHNICAL
ENGINEER AT TIME OF EXCAVATION.

NEW POOL EXCAVATION
SCALE: 1/8"=1'-0"

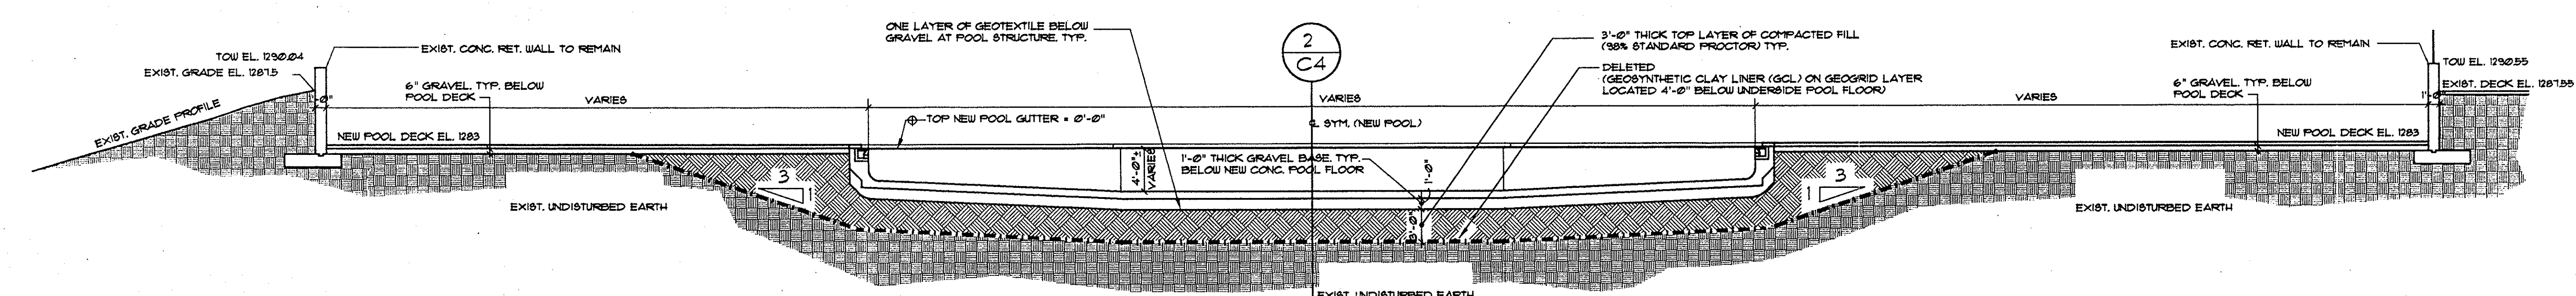

NEW POOL COMPACTED FILL
SCALE: 1/8"=1'-0"

- ENGINEERED FILL NOTES:
1. DELETED
(1/2" GEOSYNTHETIC CLAY LINER (GCL) OVERGEGRID LAYER
(TENSAR BX 1100) 4'-0" BELOW POOL FLOOR)
 2. 3'-0" OF COMPACTED FILL (98% STANDARD PROCTOR) ABOVE LAYER
AS DESCRIBED IN PARAGRAPH 1 ABOVE UP TO 1'-0" BELOW UNDERSIDE
OF POOL FLOOR.
 3. ALL PERFORATED PIPING SHALL BE INSTALLED IN GRAVEL &
ALL SOLID PIPING SHALL BE INSTALLED IN FLOWABLE FILL
TYP. UNLESS OTHERWISE NOTED.

DISTRIBUTION RECORD:		REVISION RECORD:	
ISSUED TO:	QUANTITY:	DATE:	DESCRIPTION:

planning
associates, inc.
architects
1112 McALLIE AVENUE
CHATTANOOGA, TN 37404
423-622-5121

REPLACE SWIMMING POOL
NORRIS DAM STATE PARK
LAKE CITY, TENNESSEE
SBC # 126/063-01-97A

DATE: 10/04/00
JOB #: 371
SHEET #:
C-6

FILENAME: NOR-C6
PLOT: 1/8"=1'-0"
AS-BUILT