
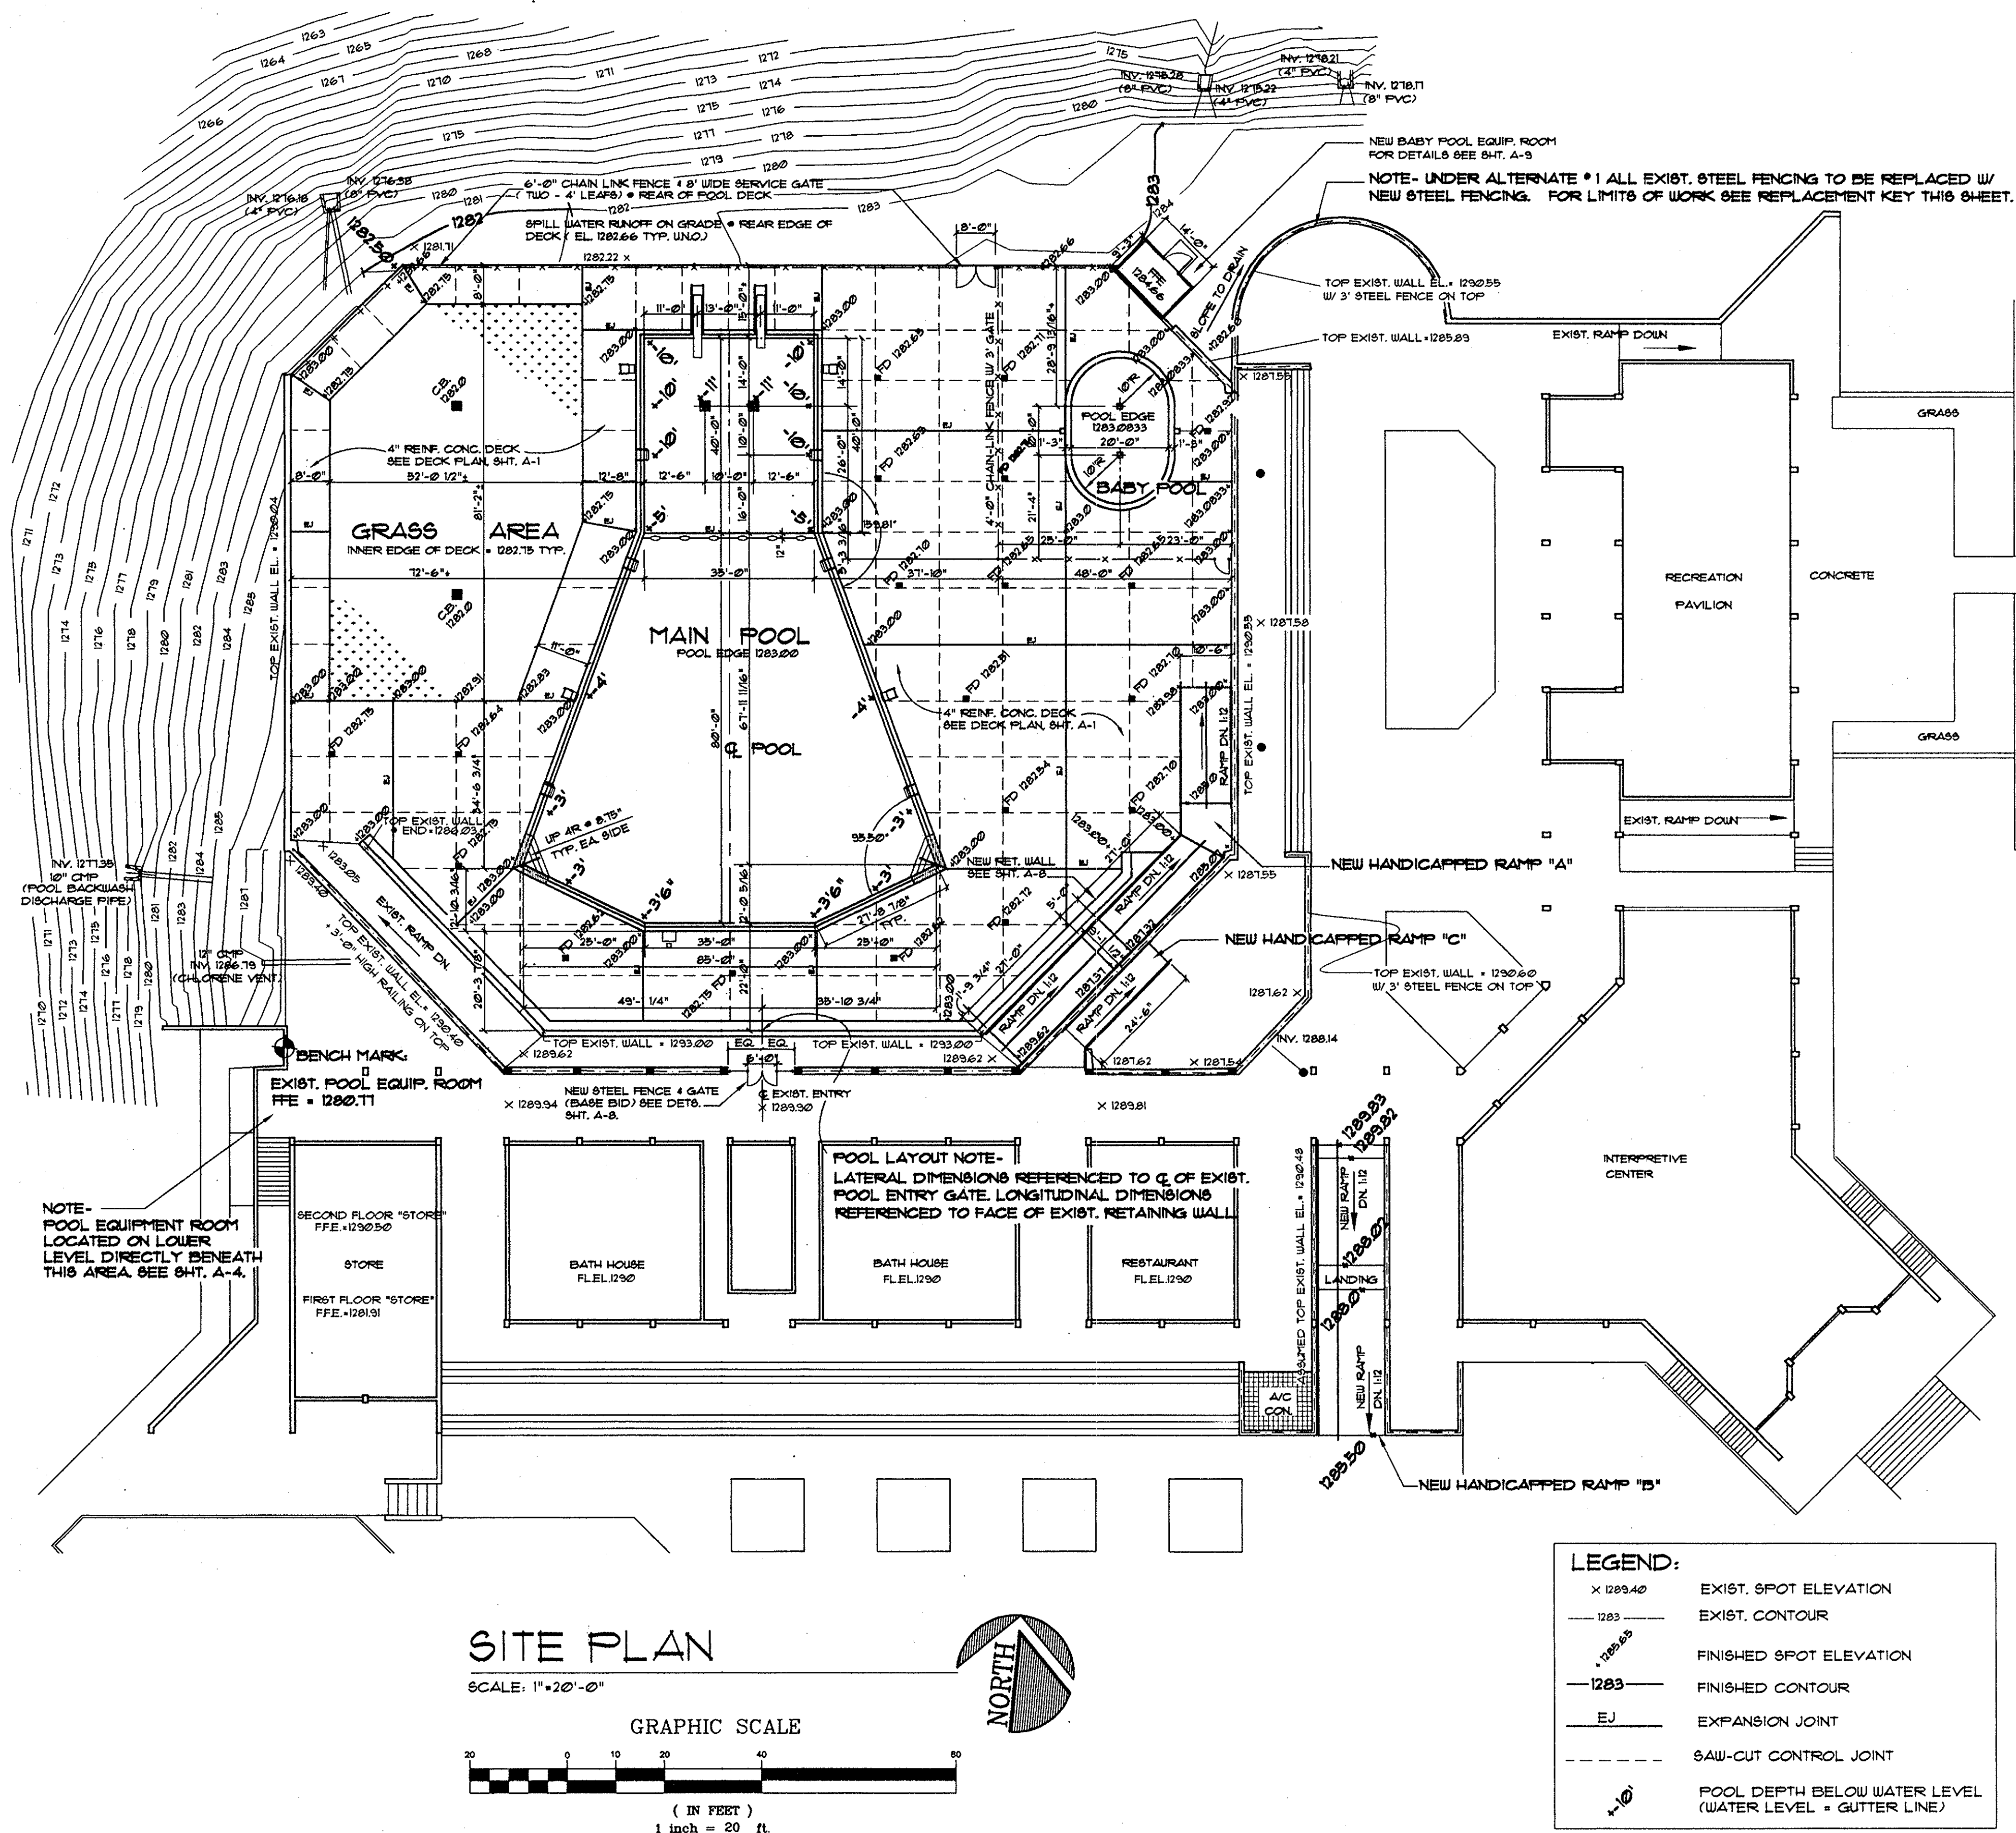


2. VALLINOS, LARRY - 5/23/2007-07:34g 79th May 05 12:42:57 2002

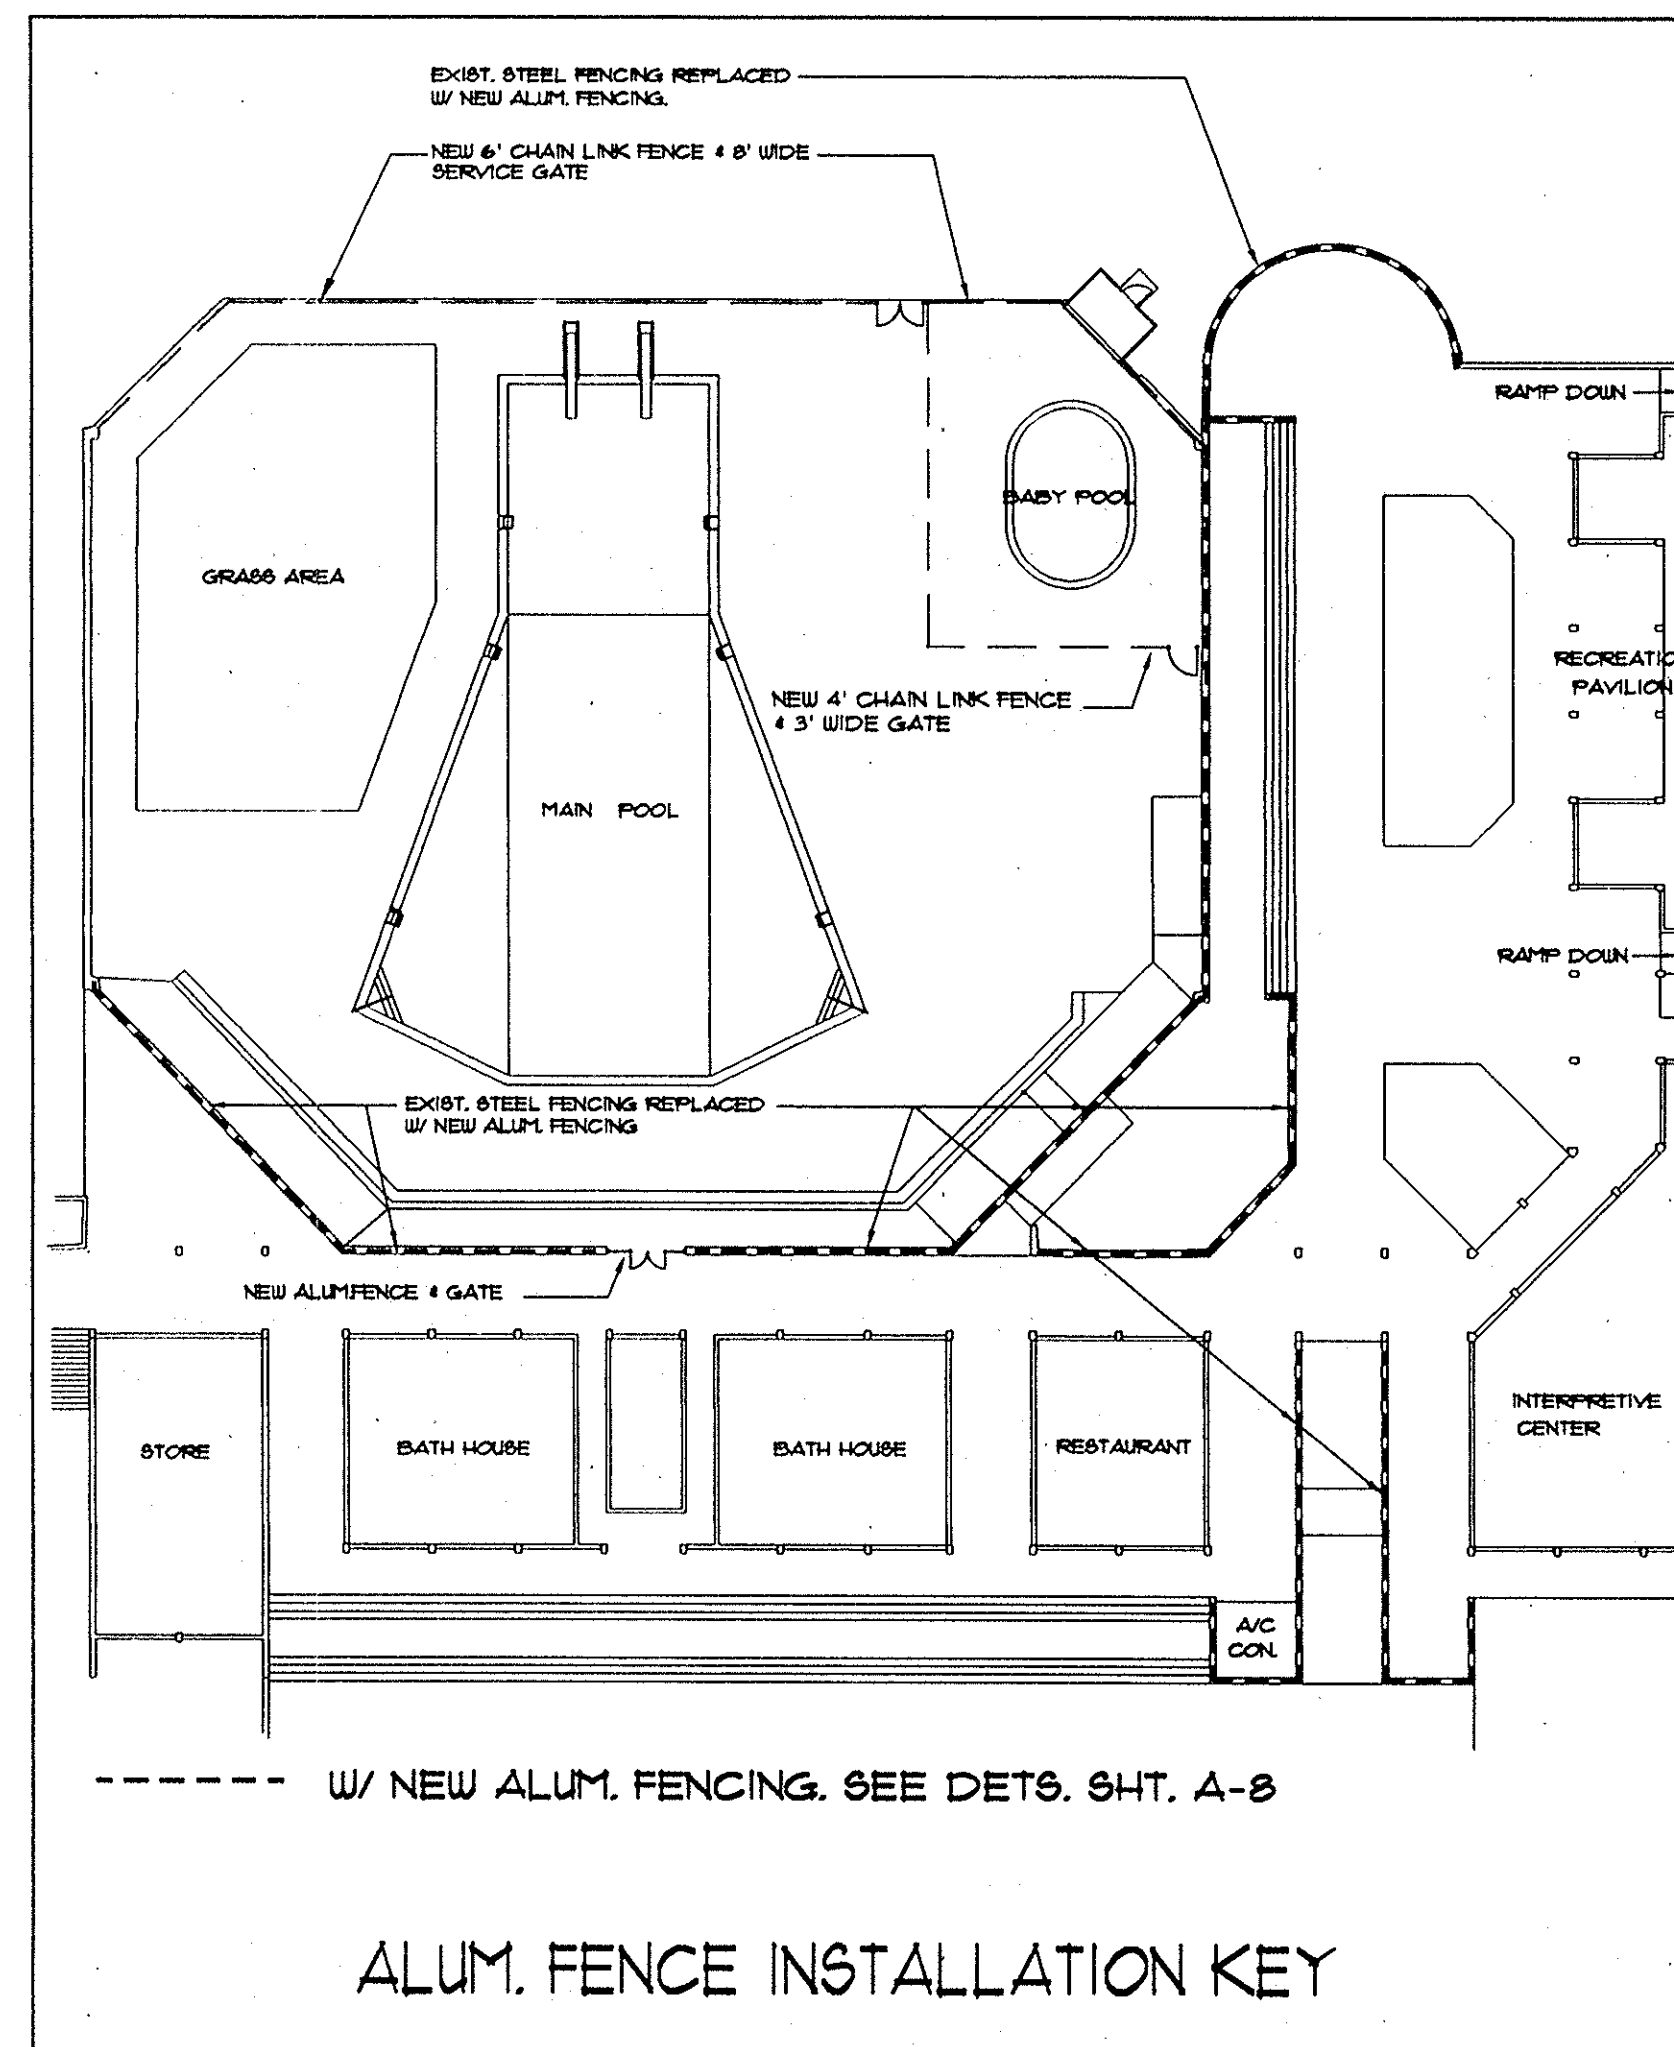

DISTRIBUTION RECORD:			REVISION RECORD:		
ISSUED TO:	QUANTITY:	DATE:	No.	DESCRIPTION:	DATE:

planning
associates, inc.
architects
1112 McCallie Avenue
Chattanooga, TN 37404
423-622-5121

REPLACE SWIMMING POOL
NORRIS DAM STATE PARK
LAKE CITY, TENNESSEE
SBC # 126/063-01-97A

DATE: 10/04/00
JOB #: 371
SHEET #: C-7

FILENAME: NOR-C7
PLOT: 1"=20'-0"
AS-BUILT