




\\va\c493\1077\505\A\07-01.dwg 9/27/03 10:22:05 2002

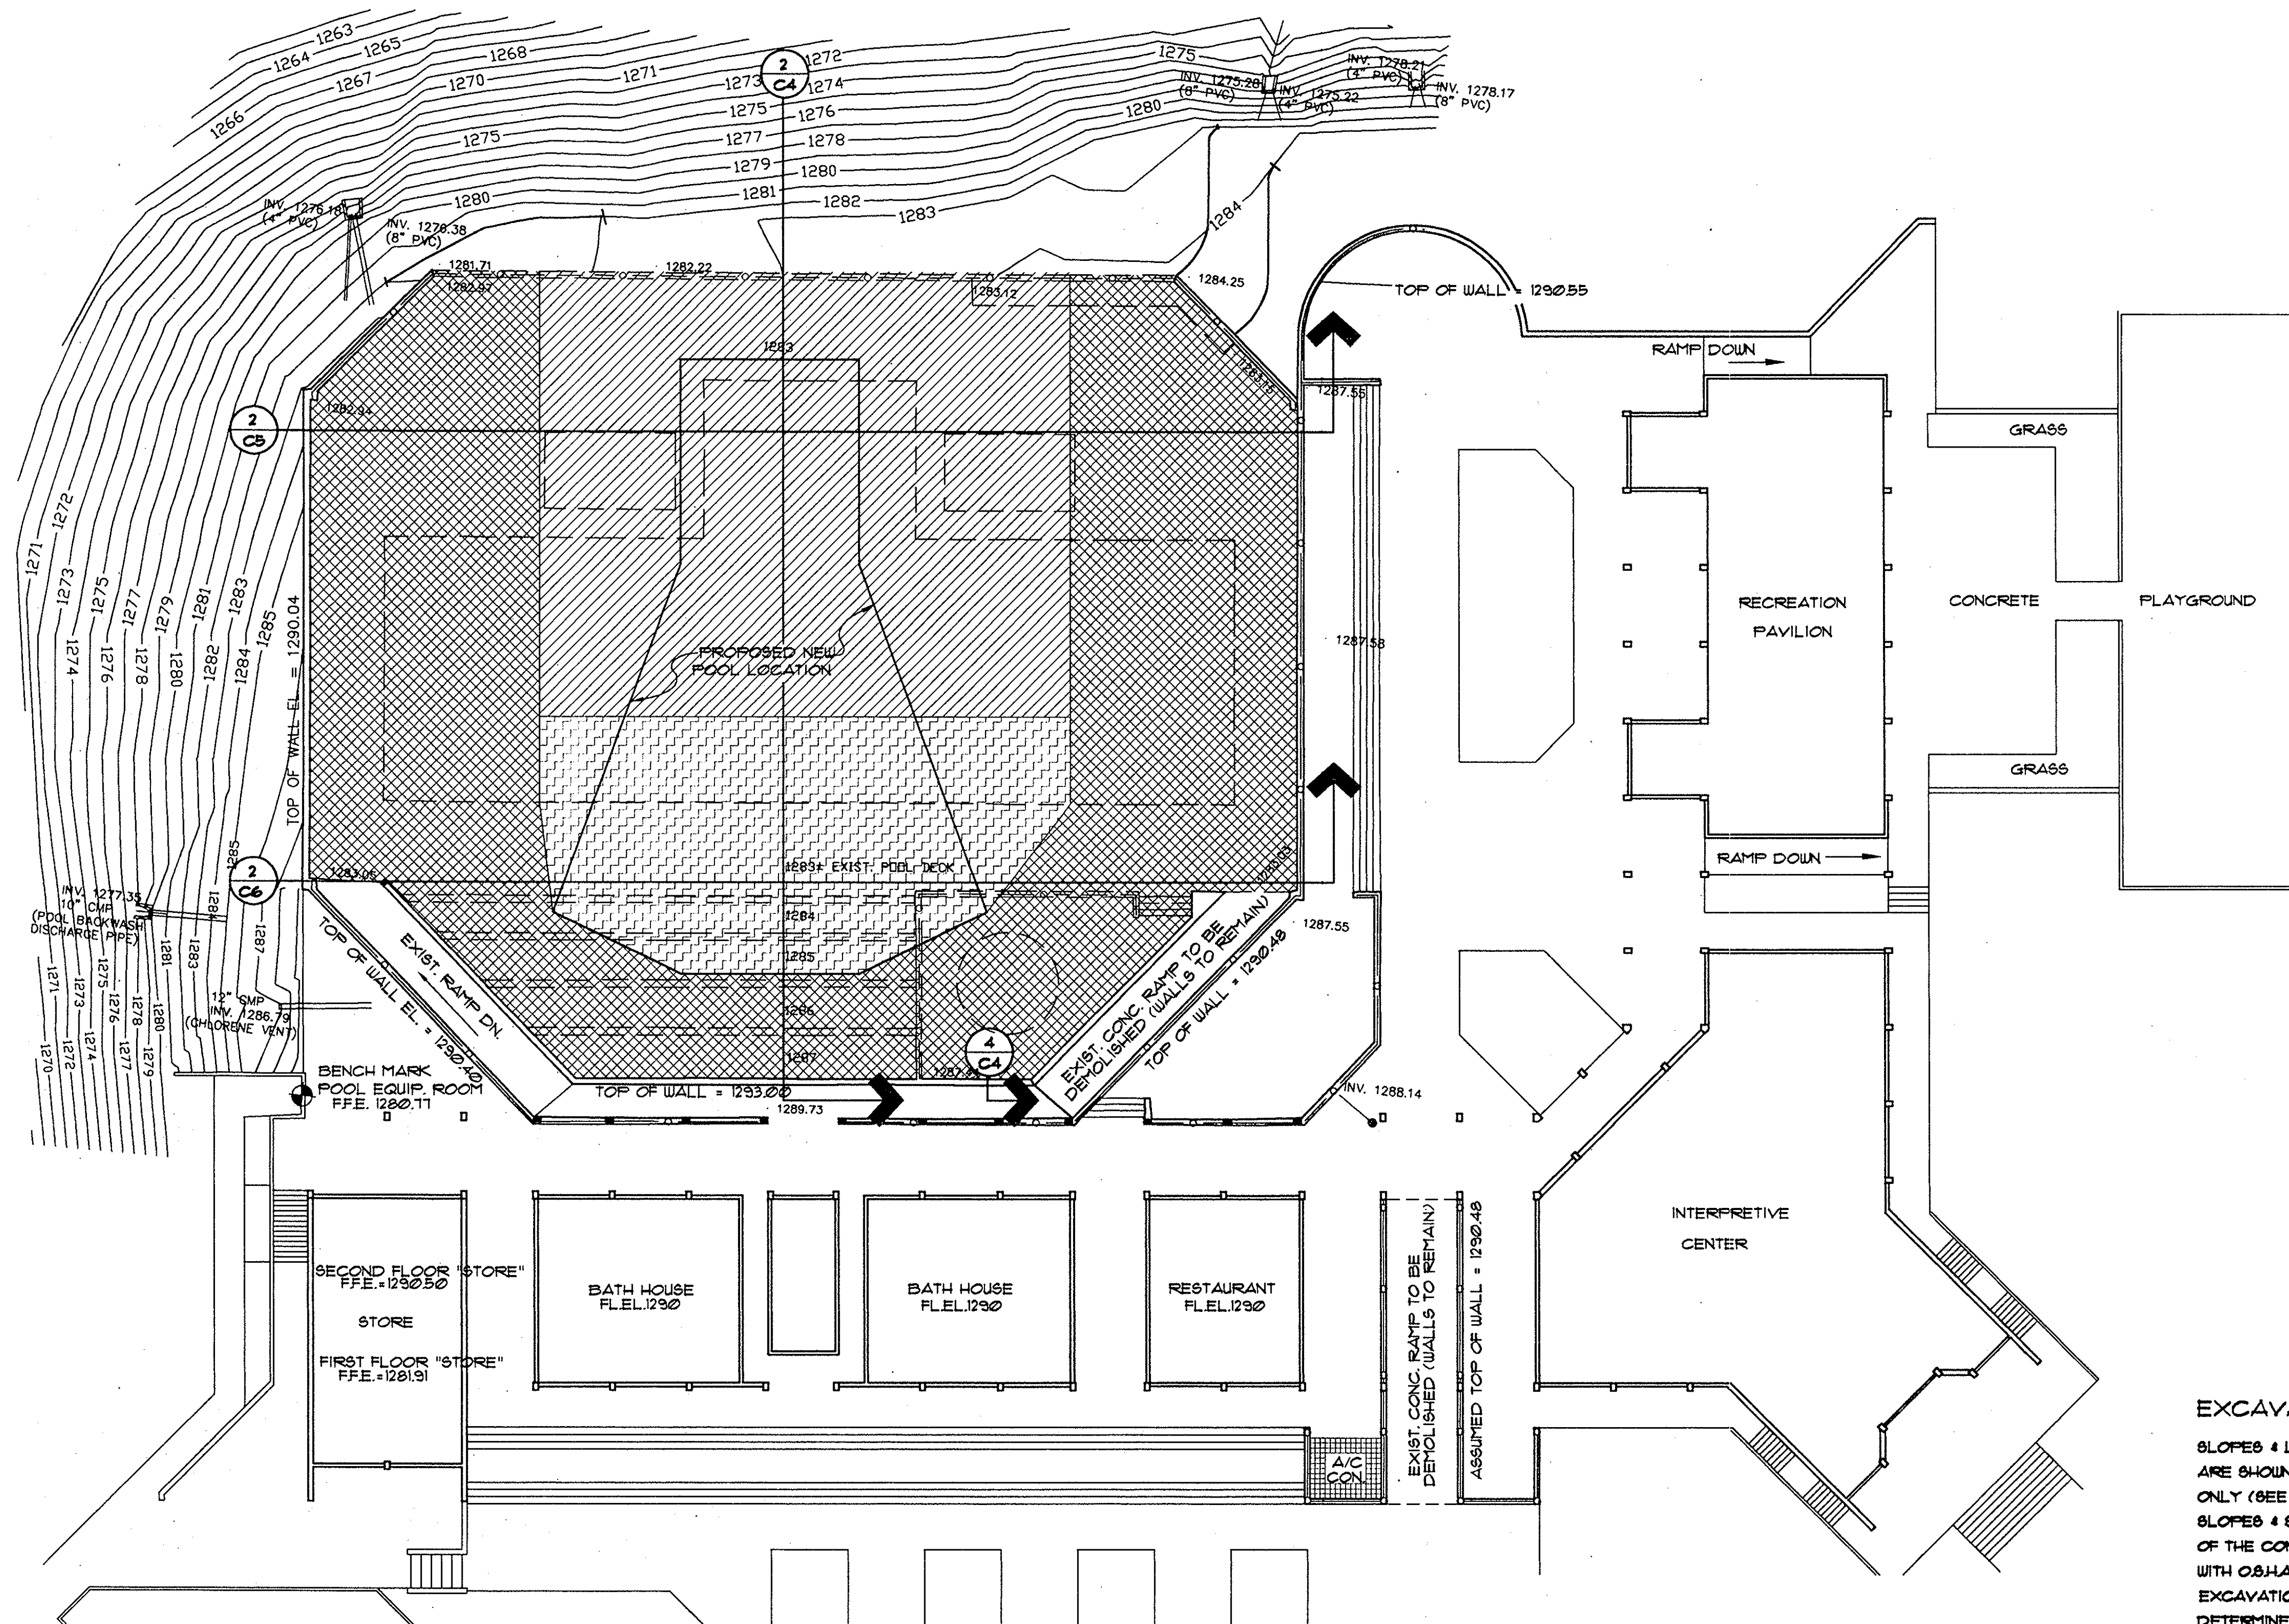

## SCHEMATIC EXCAVATION PLAN

SCALE: 1"=20'-0"

GRAPHIC SCALE

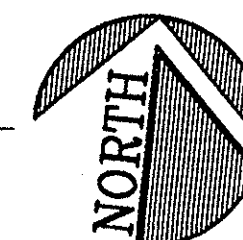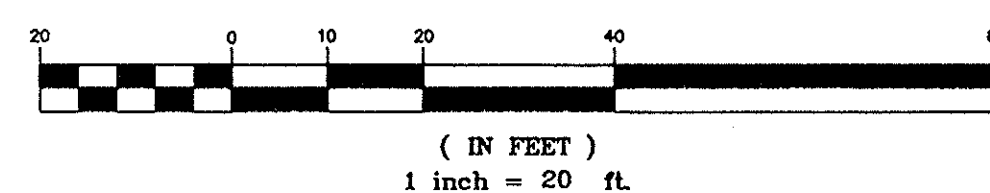

### EXCAVATION KEY:

- EXCAVATE 30' BELOW EXIST. POOL FLOOR AND EXIST. MAIN CONCRETE DECK
- EXCAVATE 1'-0" BELOW EXIST. POOL FLOOR AND EXIST. MAIN CONCRETE DECK
- EXCAVATE 4'-0" BELOW NEW POOL BOTTOM

### EXCAVATION NOTE:

SLOPES & LATERAL LIMITS OF EXCAVATION ARE SHOWN FOR ILLUSTRATIVE PURPOSES ONLY (SEE SHTS. C-4, C-5, & C-6). EXCAVATION SLOPES & STABILITY ARE THE RESPONSIBILITY OF THE CONTRACTOR & SHALL BE IN ACCORDANCE WITH OSHA STANDARDS. LATERAL LIMITS OF THE EXCAVATION WILL VARY WITH THE DEPTHS & WILL BE DETERMINED BY GEOTECHNICAL ENGINEER AT TIME OF EXCAVATION.

FILENAME: NOR-C3  
PLOT: 1"=20'-0"

AS-BUILT

DISTRIBUTION RECORD:		REVISION RECORD:	
ISSUED TO:	QUANTITY:	DATE:	DESCRIPTION:

planning  
associates, inc.  
architects  
1112 MCCALLIE AVENUE  
CHATTANOOGA, TN. 37404  
423-622-5121

REPLACE SWIMMING POOL  
NORRIS DAM STATE PARK  
LAKE CITY, TENNESSEE  
SBC # 126/063-01-97A

DATE: 10/04/00  
JOB #: 371  
SHEET #:  
C-3