


PLAN - NEW HANDICAPPED RAMP "C"
SCALE: 1/4"=1'-0"

DEMOLISH EXIST. STEPS
CONSTRUCT NEW FLAT
CONC. LANDING AS SHOWN.
NEW 4" THK CONC. SLAB (LANDING)
RE. W/ 6x6-W/4xW/4 WUF ON 6" GRAVEL
BASE ON COMPACT FILL.


EXTEND NEW OUTER HANDRAIL HORIZONTALLY AT NEW
LANDING # TERMINATE ADJACENT TO COL. AS SHOWN.

EXIST. CONC. WALL BEYOND
(NEW HANDRAILS / FENCING NOT SHOWN FOR
CLARITY. SEE SHT. A-8 FOR FENCE / RAMP DETS.)

NOTE:
PROVIDE 1 1/2" MIN. CLR.
BETWEEN HANDRAIL #
ADJACENT SURFACE.
TYP. ALL NEW HANDRAILS.

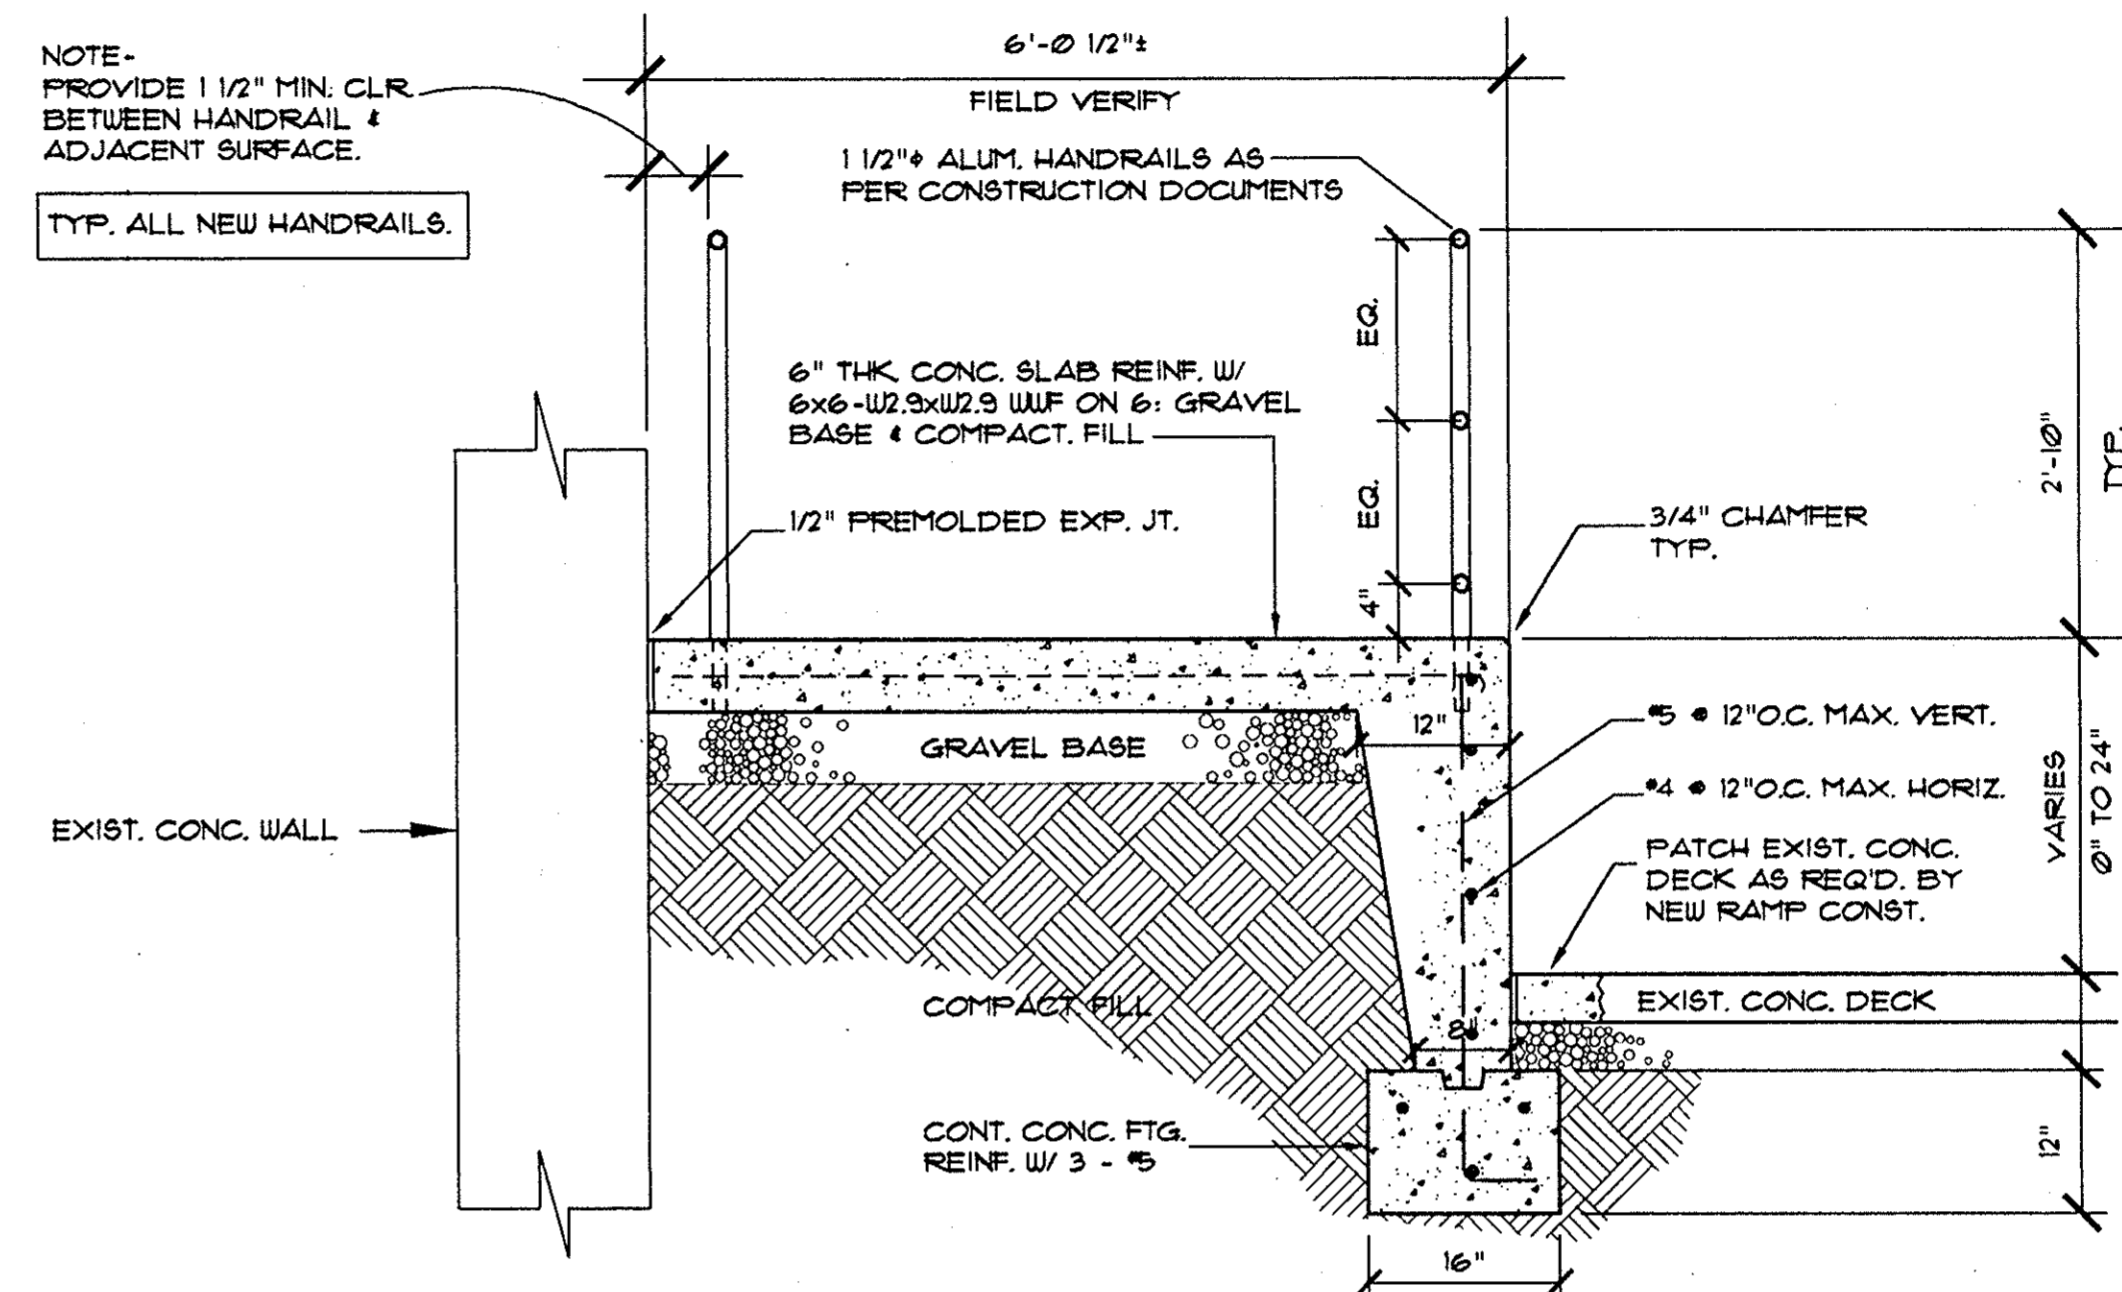


TYP. RAMP SECTION 1
SCALE: 3/4"=1'-0"

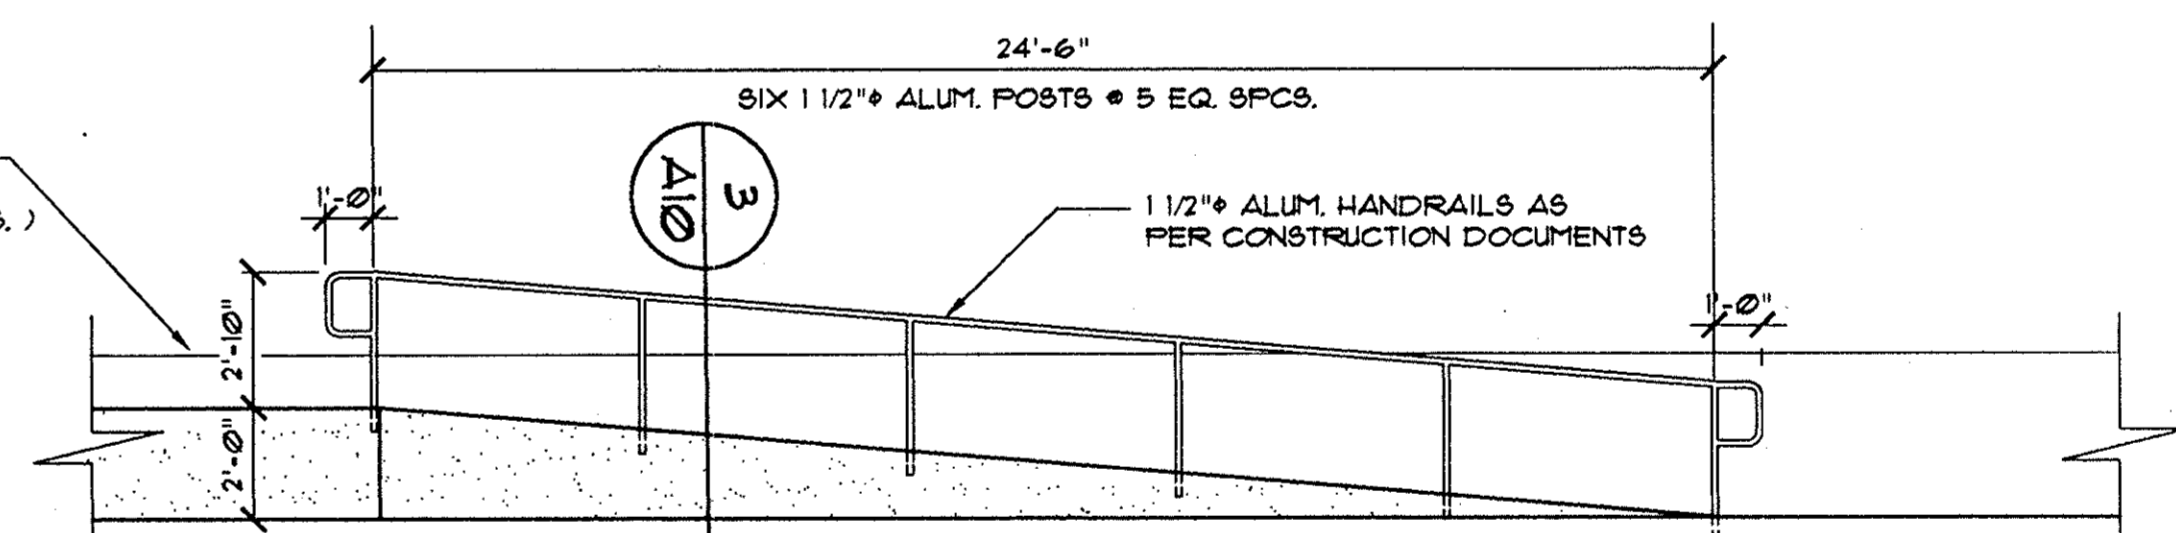

ELEVATION @ FAR SIDE 1
NTS. A10

EXTEND NEW OUTER HANDRAIL HORIZONTALLY AT NEW
LANDING # TERMINATE ADJACENT TO COL. AS SHOWN ON
RAMP FLOOR PLAN ABOVE (FIELD VERIFY DIMS.)

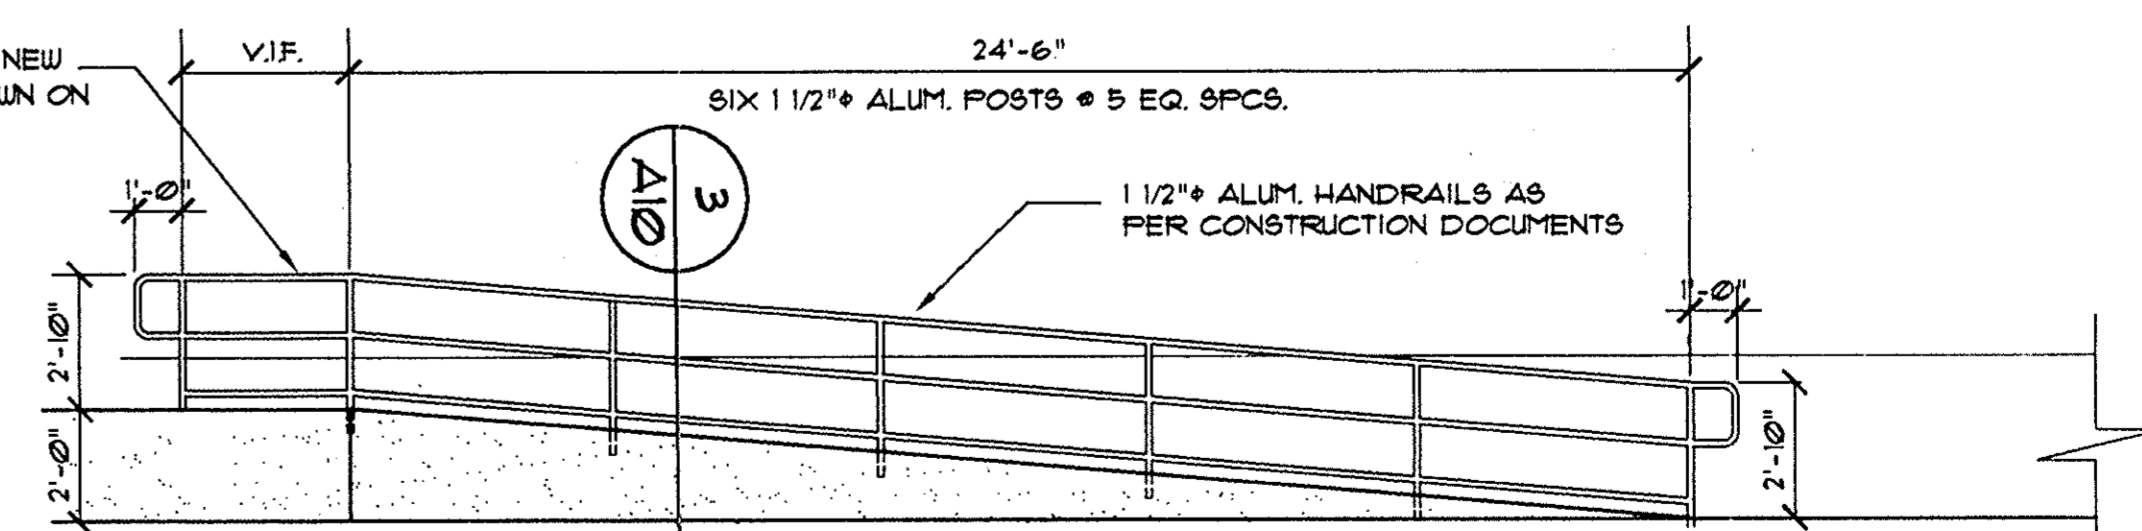

ELEVATION @ NEAR SIDE 2
NTS. A10

AS-BUILT

DISTRIBUTION RECORD:		REVISION RECORD:	
ISSUED TO:	QUANTITY:	DATE:	DESCRIPTION:

**planning
associates, inc.
architects**
1112 McCALLIE AVENUE
CHATTANOOGA, TN. 37404
423-622-5121

REPLACE SWIMMING POOL
NORRIS DAM STATE PARK
LAKE CITY, TENNESSEE
SBC # 126/063-01-97A

DATE: 10/04/00
JOB #: 371
SHEET #: **A-10**