

REPLACE SWIMMING POOL NORRIS DAM STATE PARK

LAKE CITY, TENNESSEE
SBC # 126 / 063-01-97A

ARCHITECT:
PLANNING ASSOCIATES, INC.
CHATTANOOGA, TENNESSEE


CONSULTANTS:

STRUCTURAL
MECHANICAL
ELECTRICAL


ROBINSON ASSOCIATES
BASARRATE & ASSOCIATES, INC.
VREELAND ENGINEERS, INC.

INDEX OF DRAWINGS:

CVR	COVER SHEET
SURVEY	BOUNDARY & TOPOGRAPHICAL SURVEY
C-1	EXISTING SITE PLAN
C-2	DEMOLITION PLAN
C-3	EXCAVATION PLAN
C-4	DEMOLITION, EXCAVATION, & FILL SECTIONS
C-5	DEMOLITION, EXCAVATION, & FILL SECTIONS
C-6	DEMOLITION, EXCAVATION, & FILL SECTIONS
C-7	NEW SITE PLAN
C-8	RETAINING WALL ADDITION & DETAILS
A-1	POOL & DECK PLAN
A-2	POOL SECTIONS
A-3	POOL DETAILS
A-4	MAIN POOL EQUIP. ROOM & DETAILS
A-5	POOL DECK DRAINAGE & SCORING PLAN
A-6	DELETED FROM AS- BUILT PLAN SET
A-7	DELETED FROM AS- BUILT PLAN SET
A-8	HANDICAPPED RAMP "A" & FENCE DETAILS
A-9	HANDICAPPED RAMP "B" & BABY POOL EQUIP. RM.
A-10	HANDICAPPED RAMP "C"
A-11	REMODELED BATHHOUSE PLAN
A-12	INTERIOR ELEVS. REMODELED BATHHOUSE
M-1	MECHANICAL SITE PLAN
M-2	POOL & DECK MECHANICAL PLAN
M-3	MAIN POOL EQUIPMENT PLAN & DETAILS
M-4	BABY POOL EQUIPMENT PLAN & DETAILS
SUP-8	BATHHOUSE PLUMBING PLAN, SCHEDULES & DTLs
E-1	NEW POOL & DECK ELECTRICAL PLAN
E-2	EQUIPMENT ROOM ELECTRICAL PLANS
SUP-9	BATHHOUSE ELECTRICAL PLAN & SCHEDULES

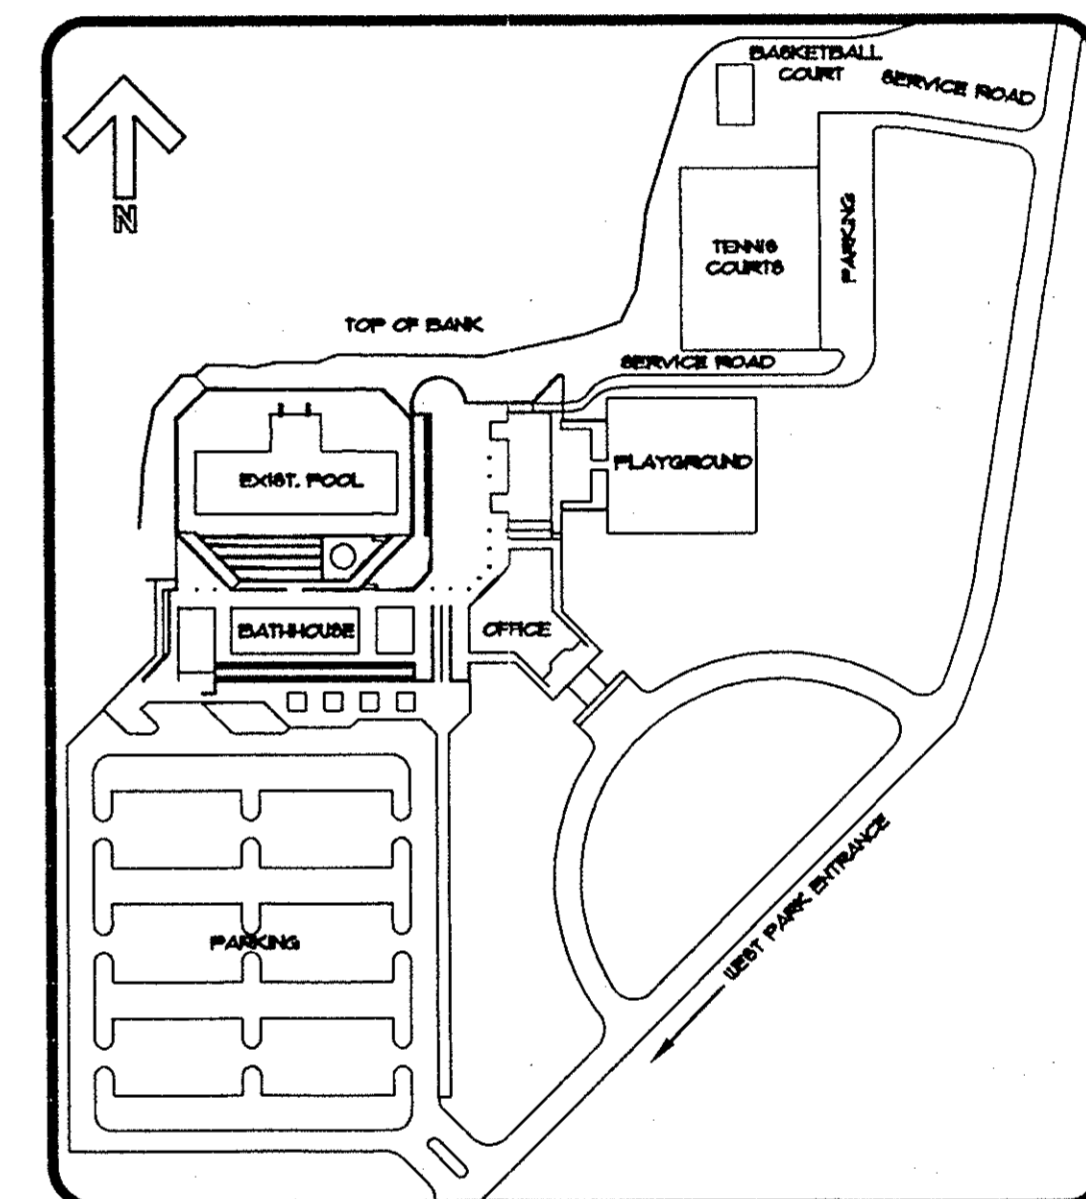

SITE LOCATION MAP
NTA.

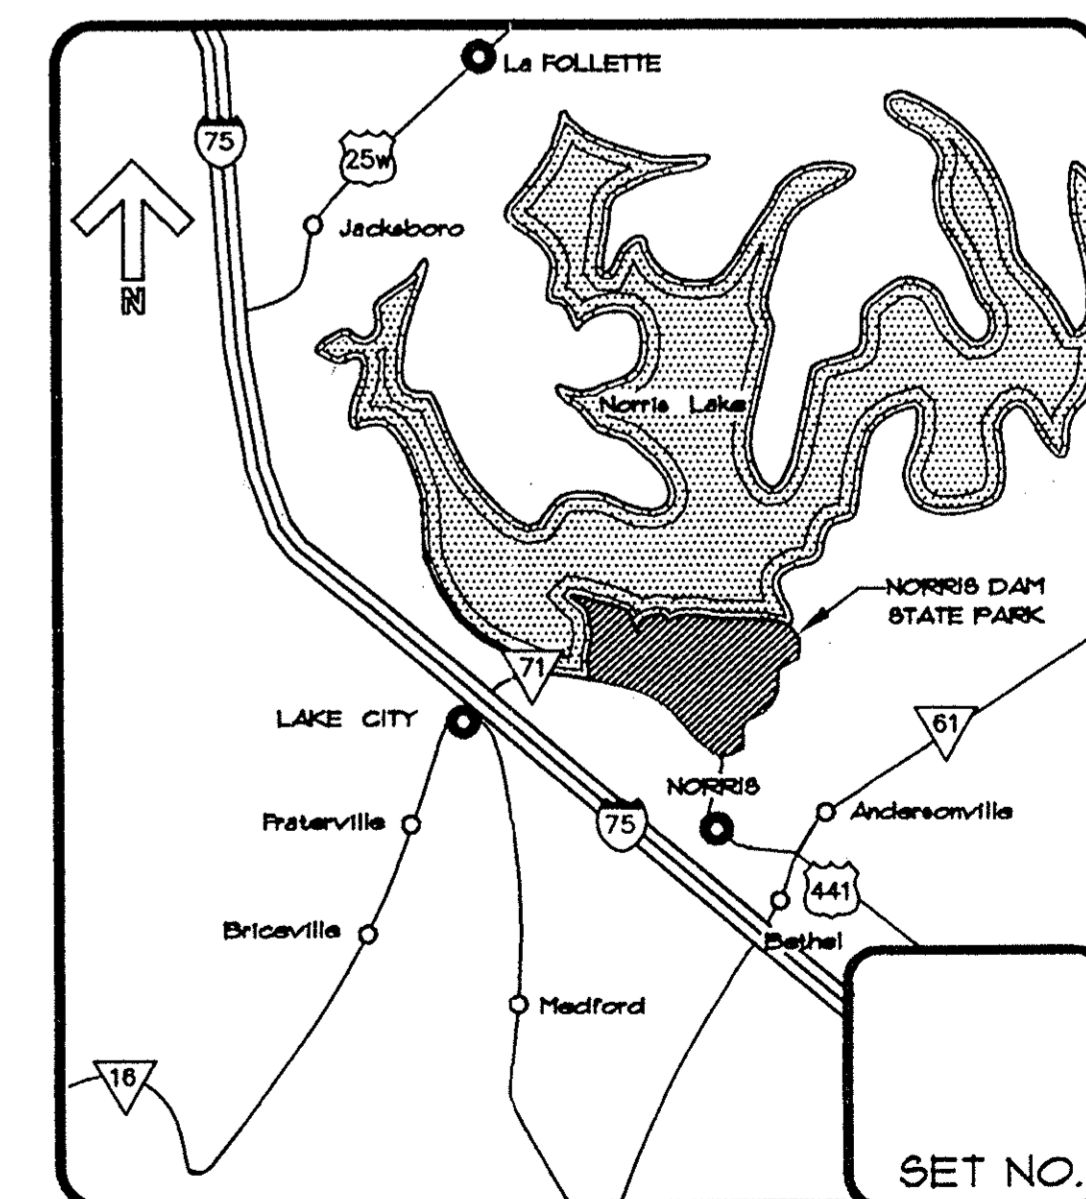

SITE VICINITY MAP
NTA.

AS-BUILT

DISTRIBUTION RECORD:		REVISION RECORD:	
ISSUED TO:	QUANTITY:	No.	DESCRIPTION:

planning
associates, inc.
architects
1112 McALLIE AVENUE
CHATTANOOGA, TN 37404
423-622-5121

REPLACE SWIMMING POOL
NORRIS DAM STATE PARK
LAKE CITY, TENNESSEE
SBC # 126/063-01-97A

DATE: 10/04/00
JOB #: 371
SHEET #:
CVR