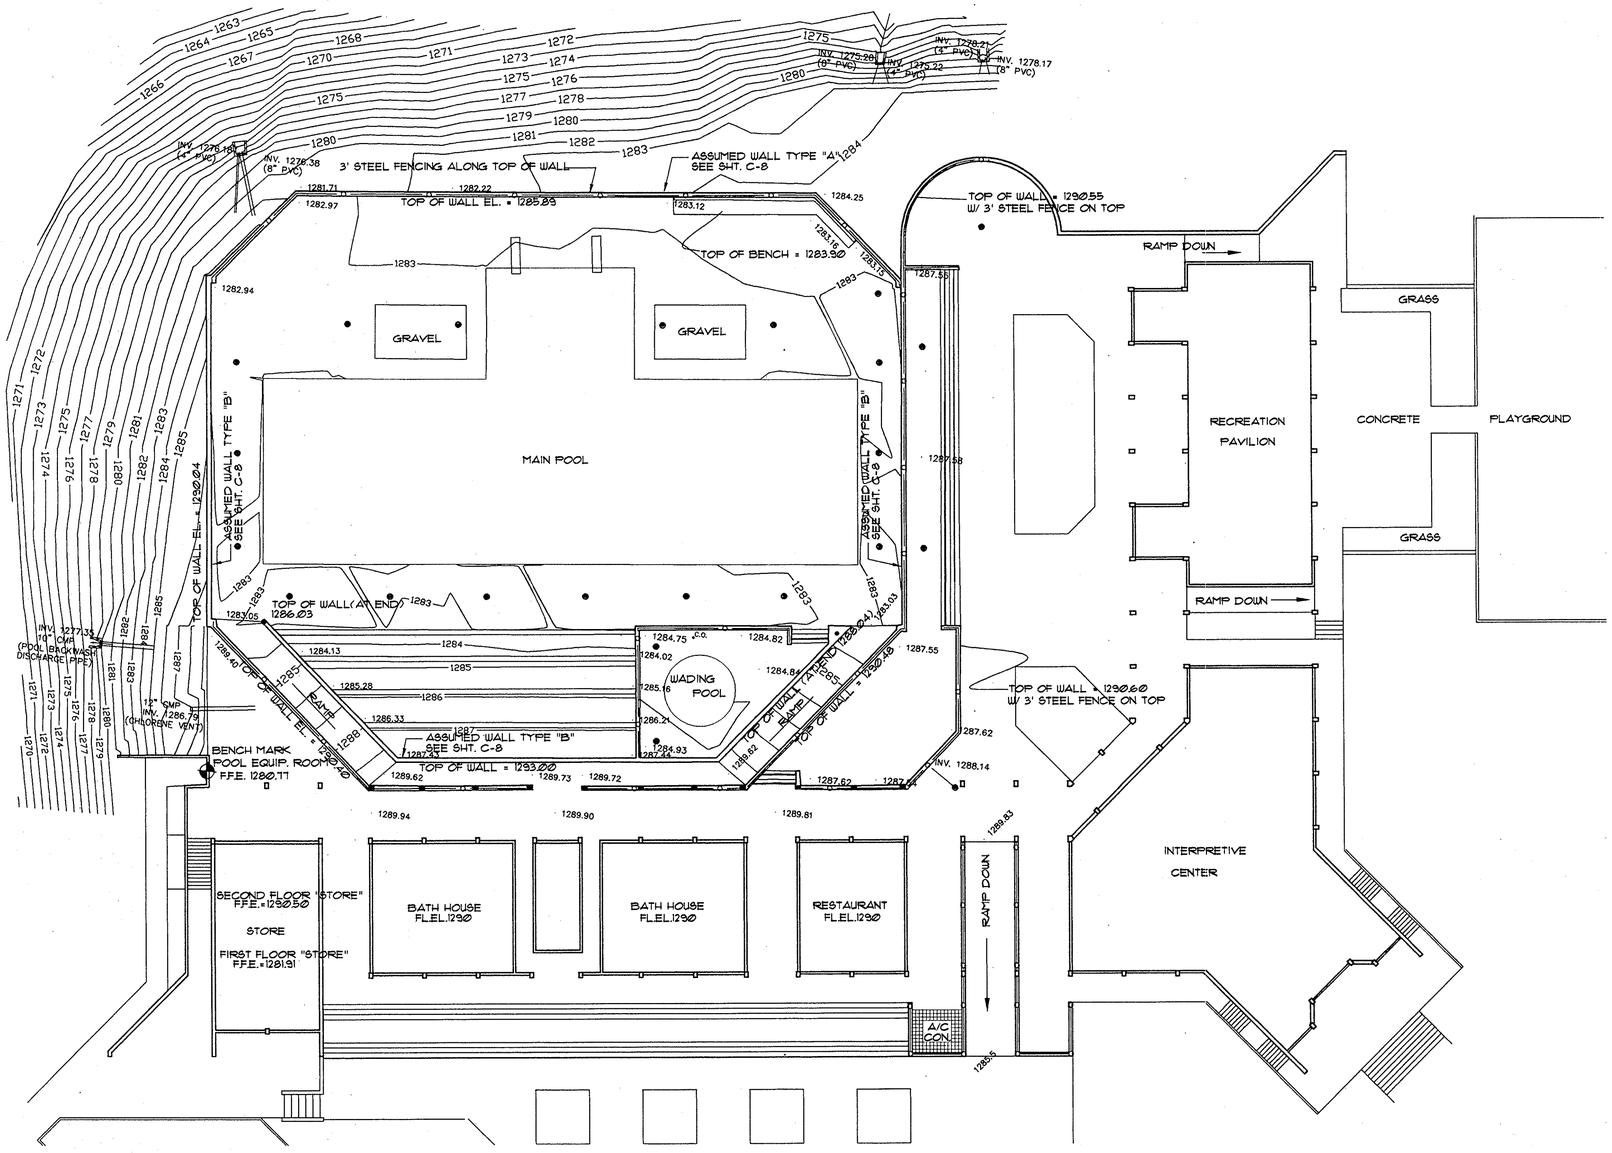

EXISTING SITE PLAN (PRIOR TO NEW CONSTRUCTION)

SCALE: 1"=20'-0"

NORTH

GRAPHIC SCALE

20 0 10 20 40 80

(IN FEET)
1 inch = 20 ft.

FILENAME: NOR-C1
PLOT: 1"=20'-0"

AS-BUILT

DISTRIBUTION RECORD:

ISSUED TO: | QUANTITY: | DATE:

REVISION RECORD:

No.	DESCRIPTION:	DATE:

planning associates, inc.
architects
1112 McCALLIE AVENUE
CHATTANOOGA, TN. 37404
423-622-5121

REPLACE SWIMMING POOL
NORRIS DAM STATE PARK
LAKE CITY, TENNESSEE
SBC # 126/063-01-97A

DATE: 10/04/00
JOB #: 371
SHEET #: C-1