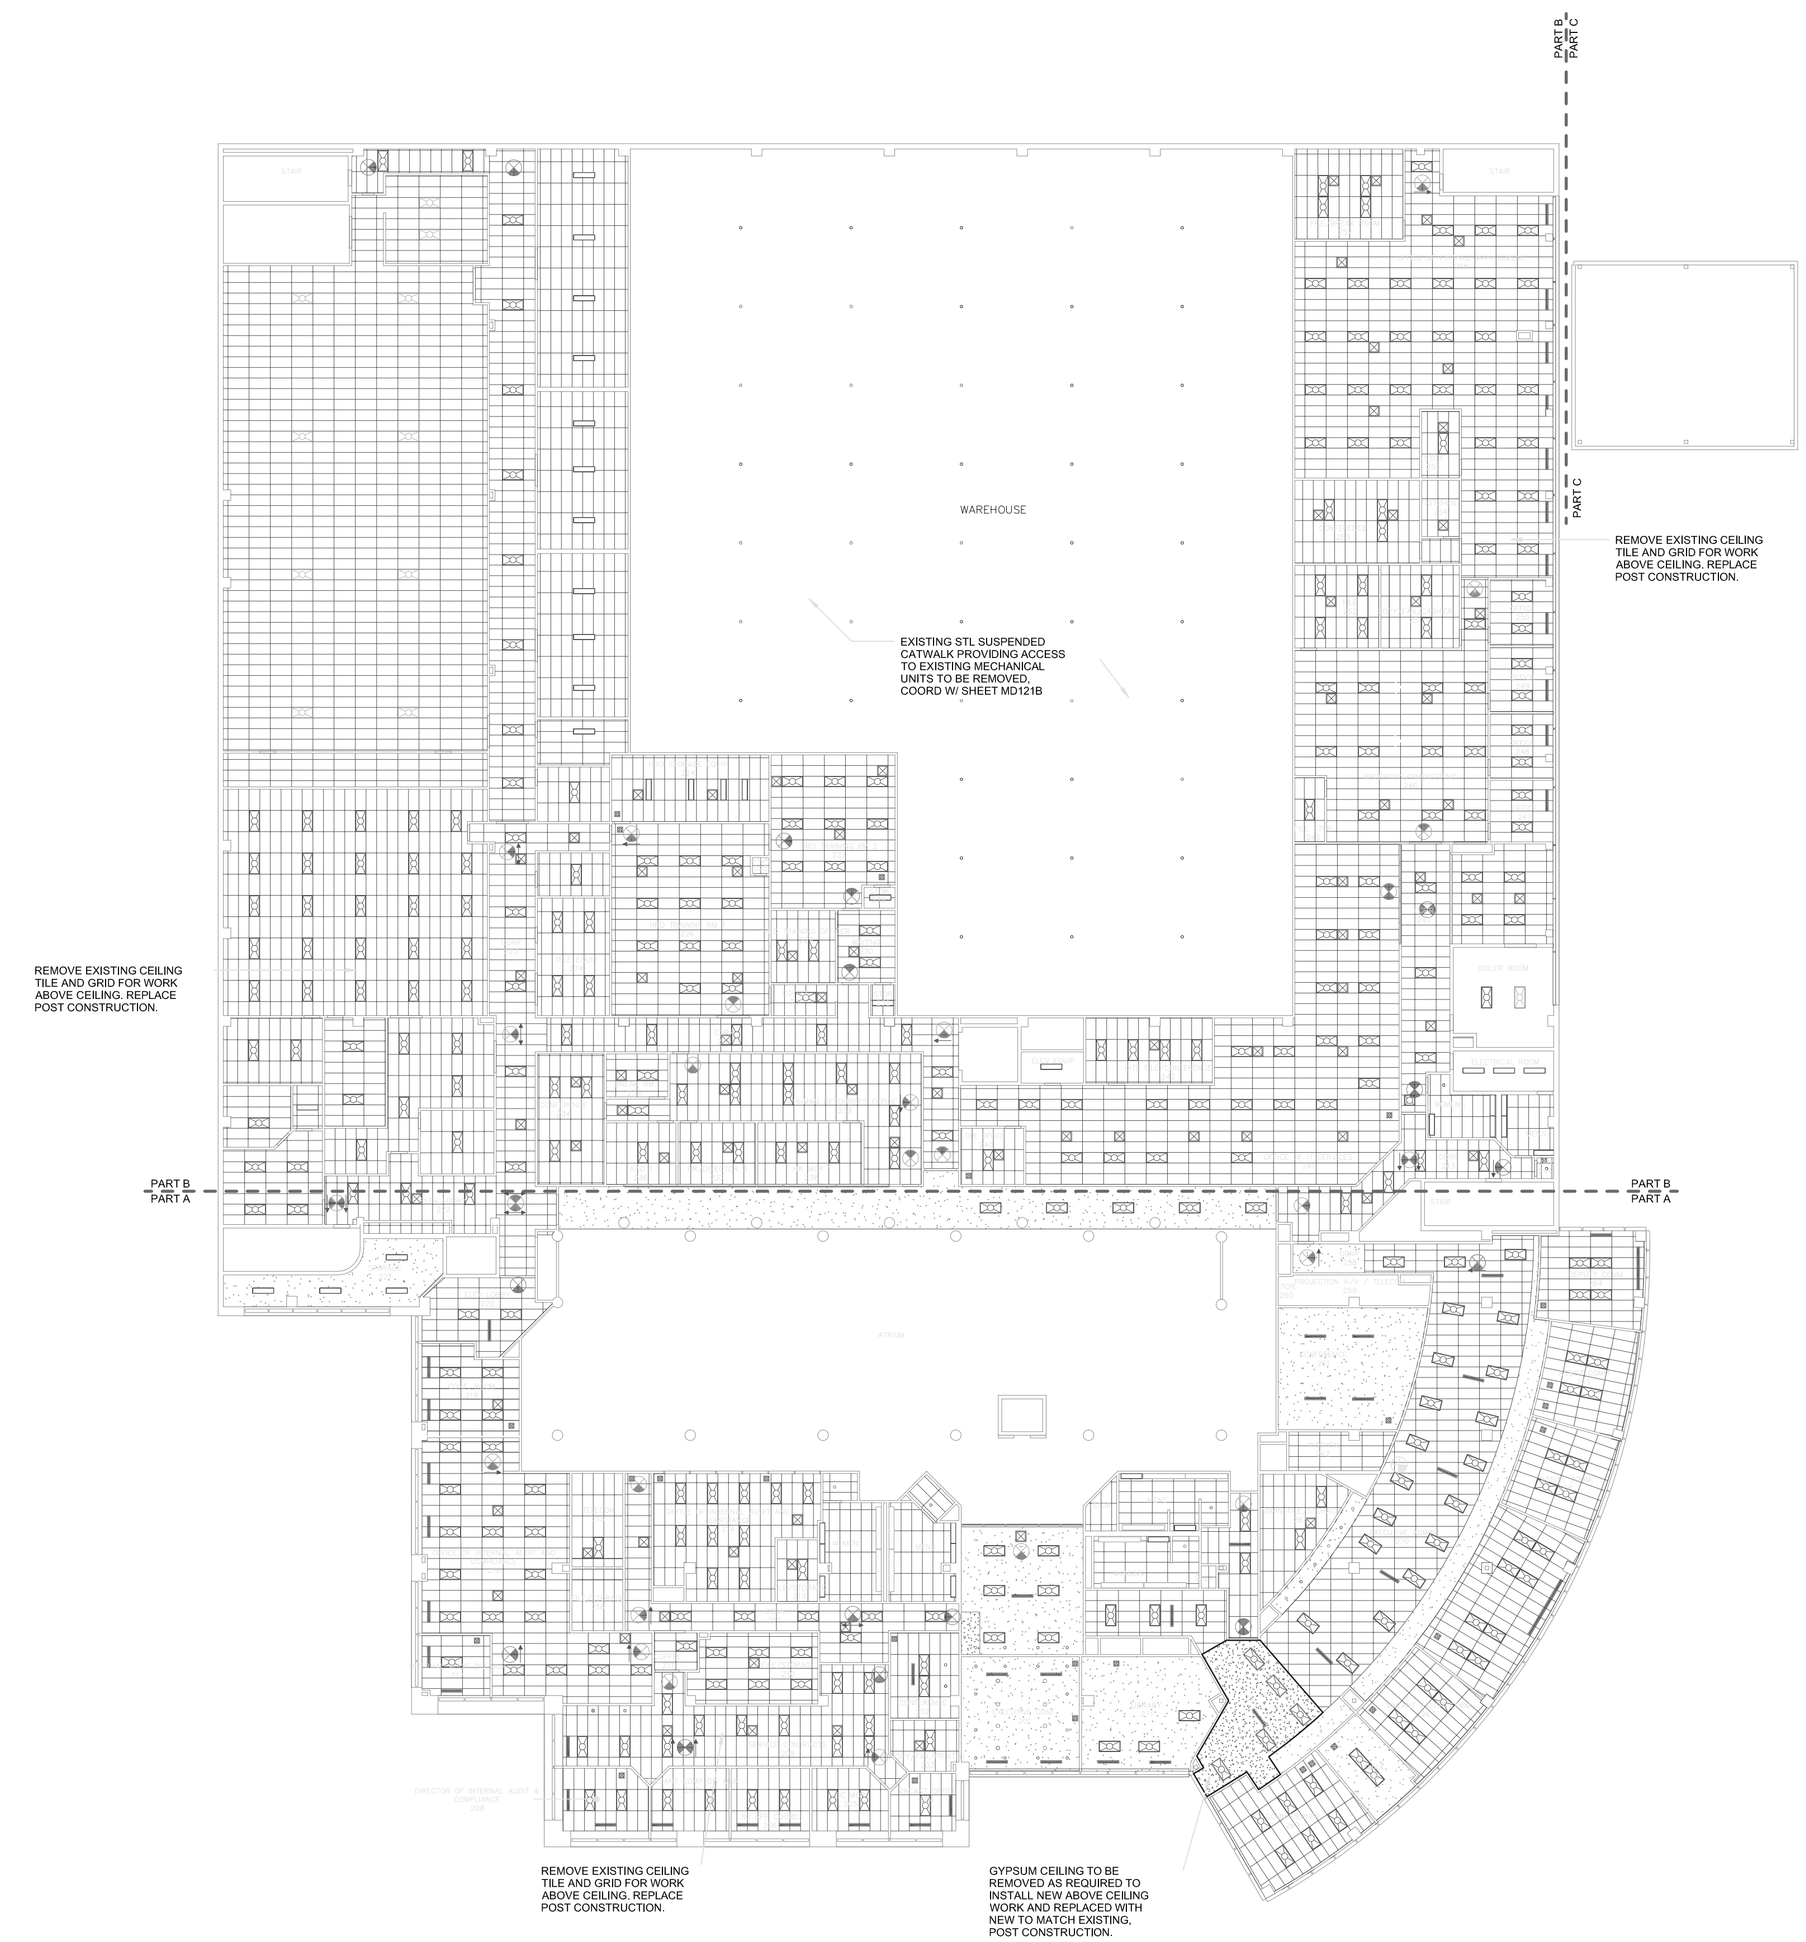

OVERALL SECOND FLOOR RCP DEMOLITION PLAN

0 8 16 32 48 FEET

CEILING DEMOLITION GENERAL NOTES

1. COORDINATE EXTENT OF CEILING REMOVAL WITH MECHANICAL AND ELECTRICAL WORK ABOVE CEILING.

2. CONTRACTOR TO COORDINATE ALL DEMOLITION AND NEW WORK WITH ALL CONSTRUCTION DISCIPLINES.

3. PROTECT EXISTING FIREPROOFING, TYP. REPAIR IF DAMAGED.

4. CONTRACTOR SHALL SALVAGE CEILING MATERIAL AND GRID AND REPLACE POST CONSTRUCTION. DAMAGED CEILINGS AND GRID WILL BE REPLACED WITH NEW TO MATCH EXISTING.

LEGEND

- EXISTING GYPSUM BOARD CEILING
- EXISTING GYPSUM BOARD CEILING AND SUPPORT SYSTEM TO BE REMOVED AND REPLACED WITH NEW TO MATCH EXISTING
- EXISTING 2x4 ACT CEILING
- EXISTING EXIT LIGHT
- EXISTING 2x4 RECESSED FLOURESCENT LIGHT FIXTURE
- EXISTING 2x2 RECESSED FLOURESCENT LIGHT FIXTURE
- EXISTING RECESSED DOWNLIGHT
- EXISTING 1x4 RECESSED FLOURESCENT LIGHT FIXTURE
- EXISTING 1x8 RECESSED FLOURESCENT LIGHT FIXTURE
- EXISTING SLOT DIFFUSER (SUPPLY & RETURN)
- EXISTING SUPPLY DIFFUSER
- EXISTING RETURN DIFFUSERS AND EXHAUST

RECORD DRAWING

THIS RECORD DRAWING HAS BEEN PREPARED BY THOMAS MILLER & PARTNERS BASED ON THE INFORMATION PROVIDED BY THE GENERAL CONTRACTOR. IT IS NOT THE RESPONSIBILITY OF THE ARCHITECT TO VERIFY THE RECORD DRAWINGS INFORMATION PROVIDED BY THE GENERAL CONTRACTOR.

INTERIOR RENOVATIONS / ESSENTIAL MAINTENANCE PHASE 2
PIEDMONT GAS BUILDING
NASHVILLE, TN
SBC PROJ. No.
529/012-01-2009-01

OVERALL SECOND FLOOR RCP DEMOLITION PLAN

D220

DATE: 07/29/2011 REVISIONS:
JOB NO.A03309.00
DR. BY: JC
CK. BY: WJ

ARCHITECTURE ▪ INTERIOR DESIGN ▪ PLANNING ▪ 5210 MARYLAND WAY SUITE E200 BRENTWOOD, TN 37027 ▪ PHONE 615 377-9773 ▪ FAX 615 370-4147 ▪ WWW.TMPARTNERS.COM
THOMAS MILLER & PARTNERS